

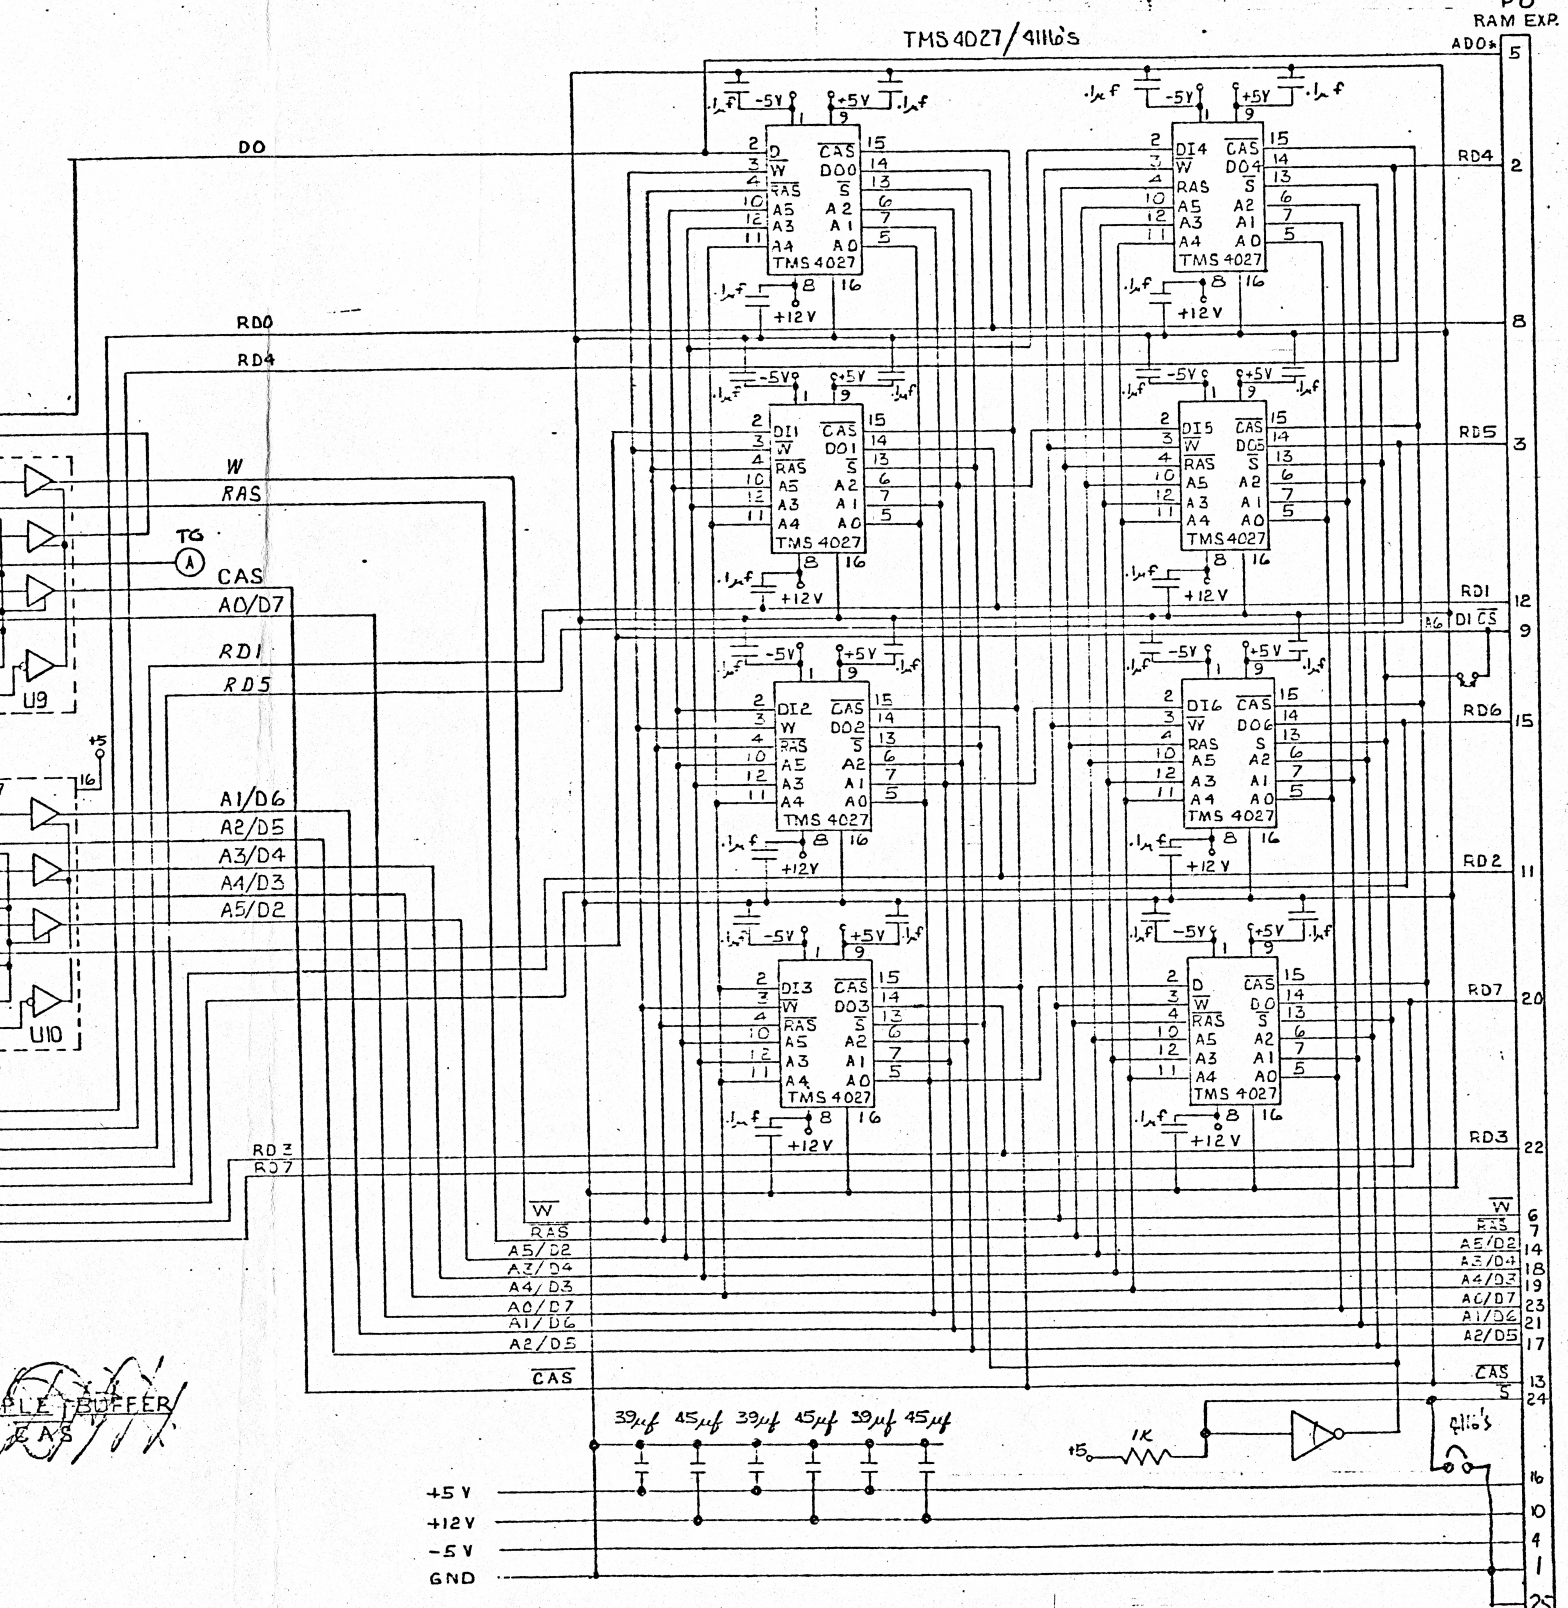
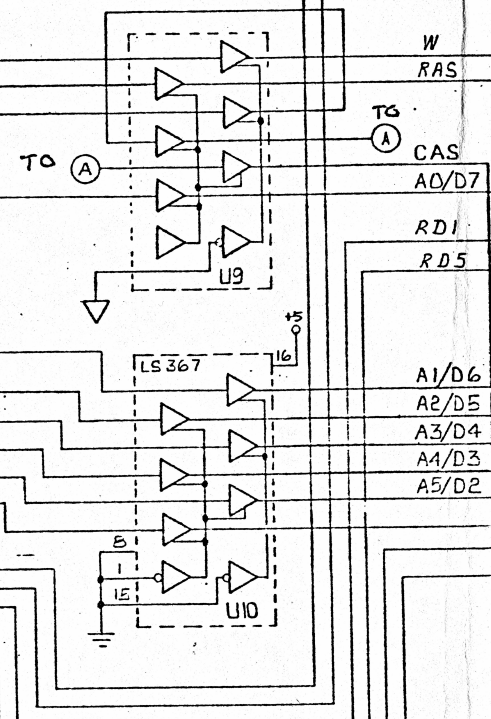
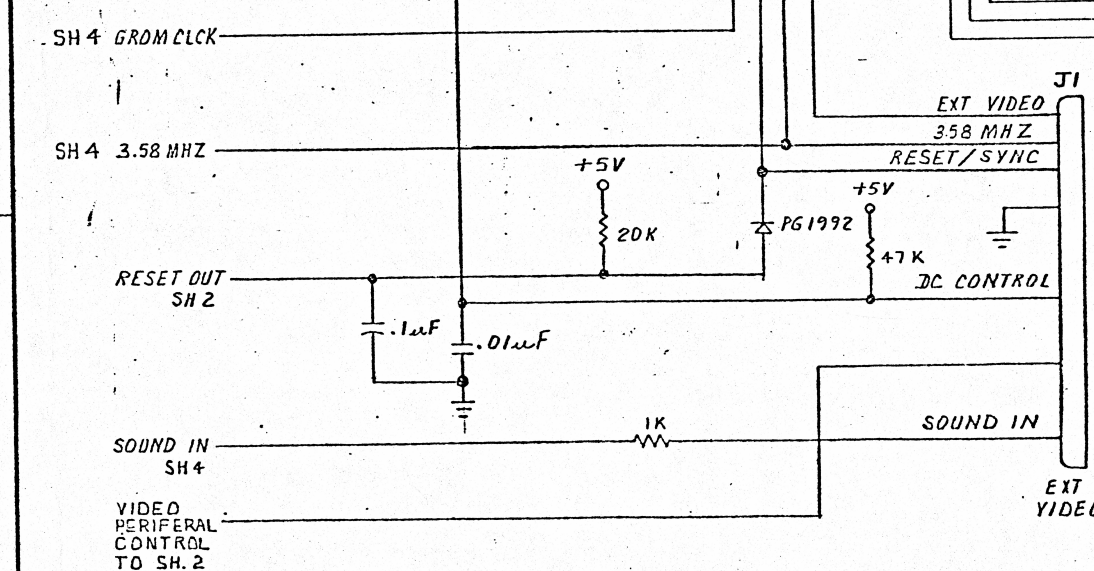
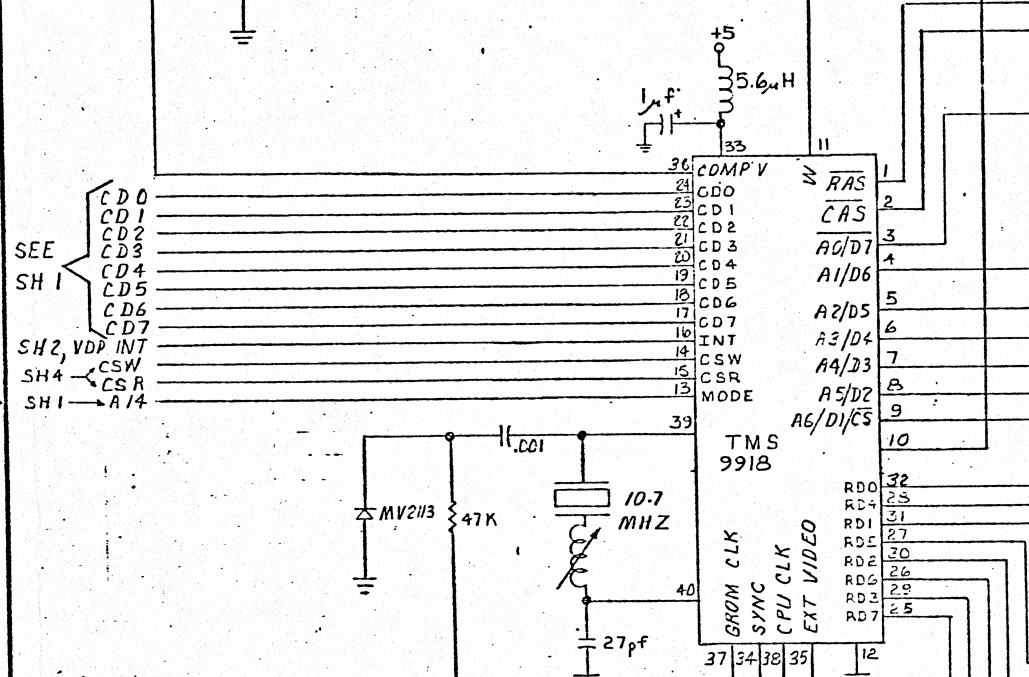


8 7 6 5 4 3 2 1
CB WILSON

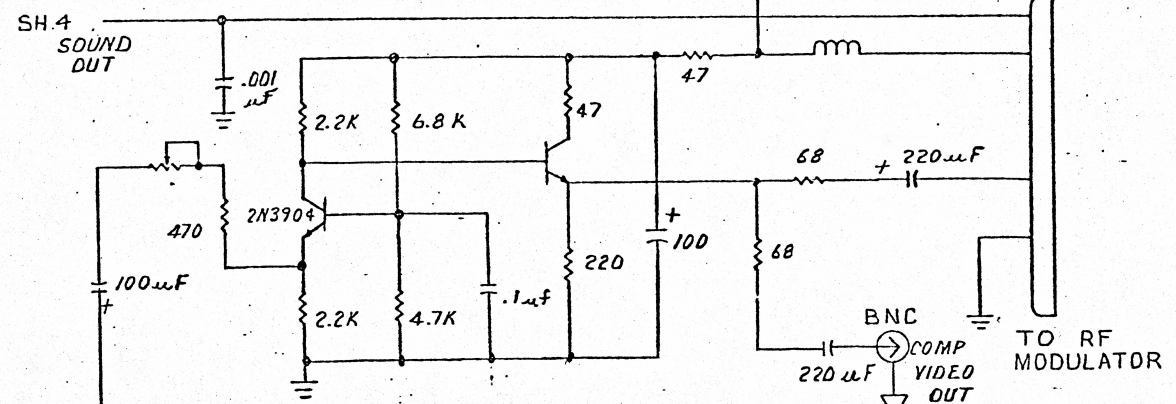

~~TRIPLE BUFFER~~
~~RAM~~

NOTE ON (A): CAS IS TRIPLE BUFFERED.

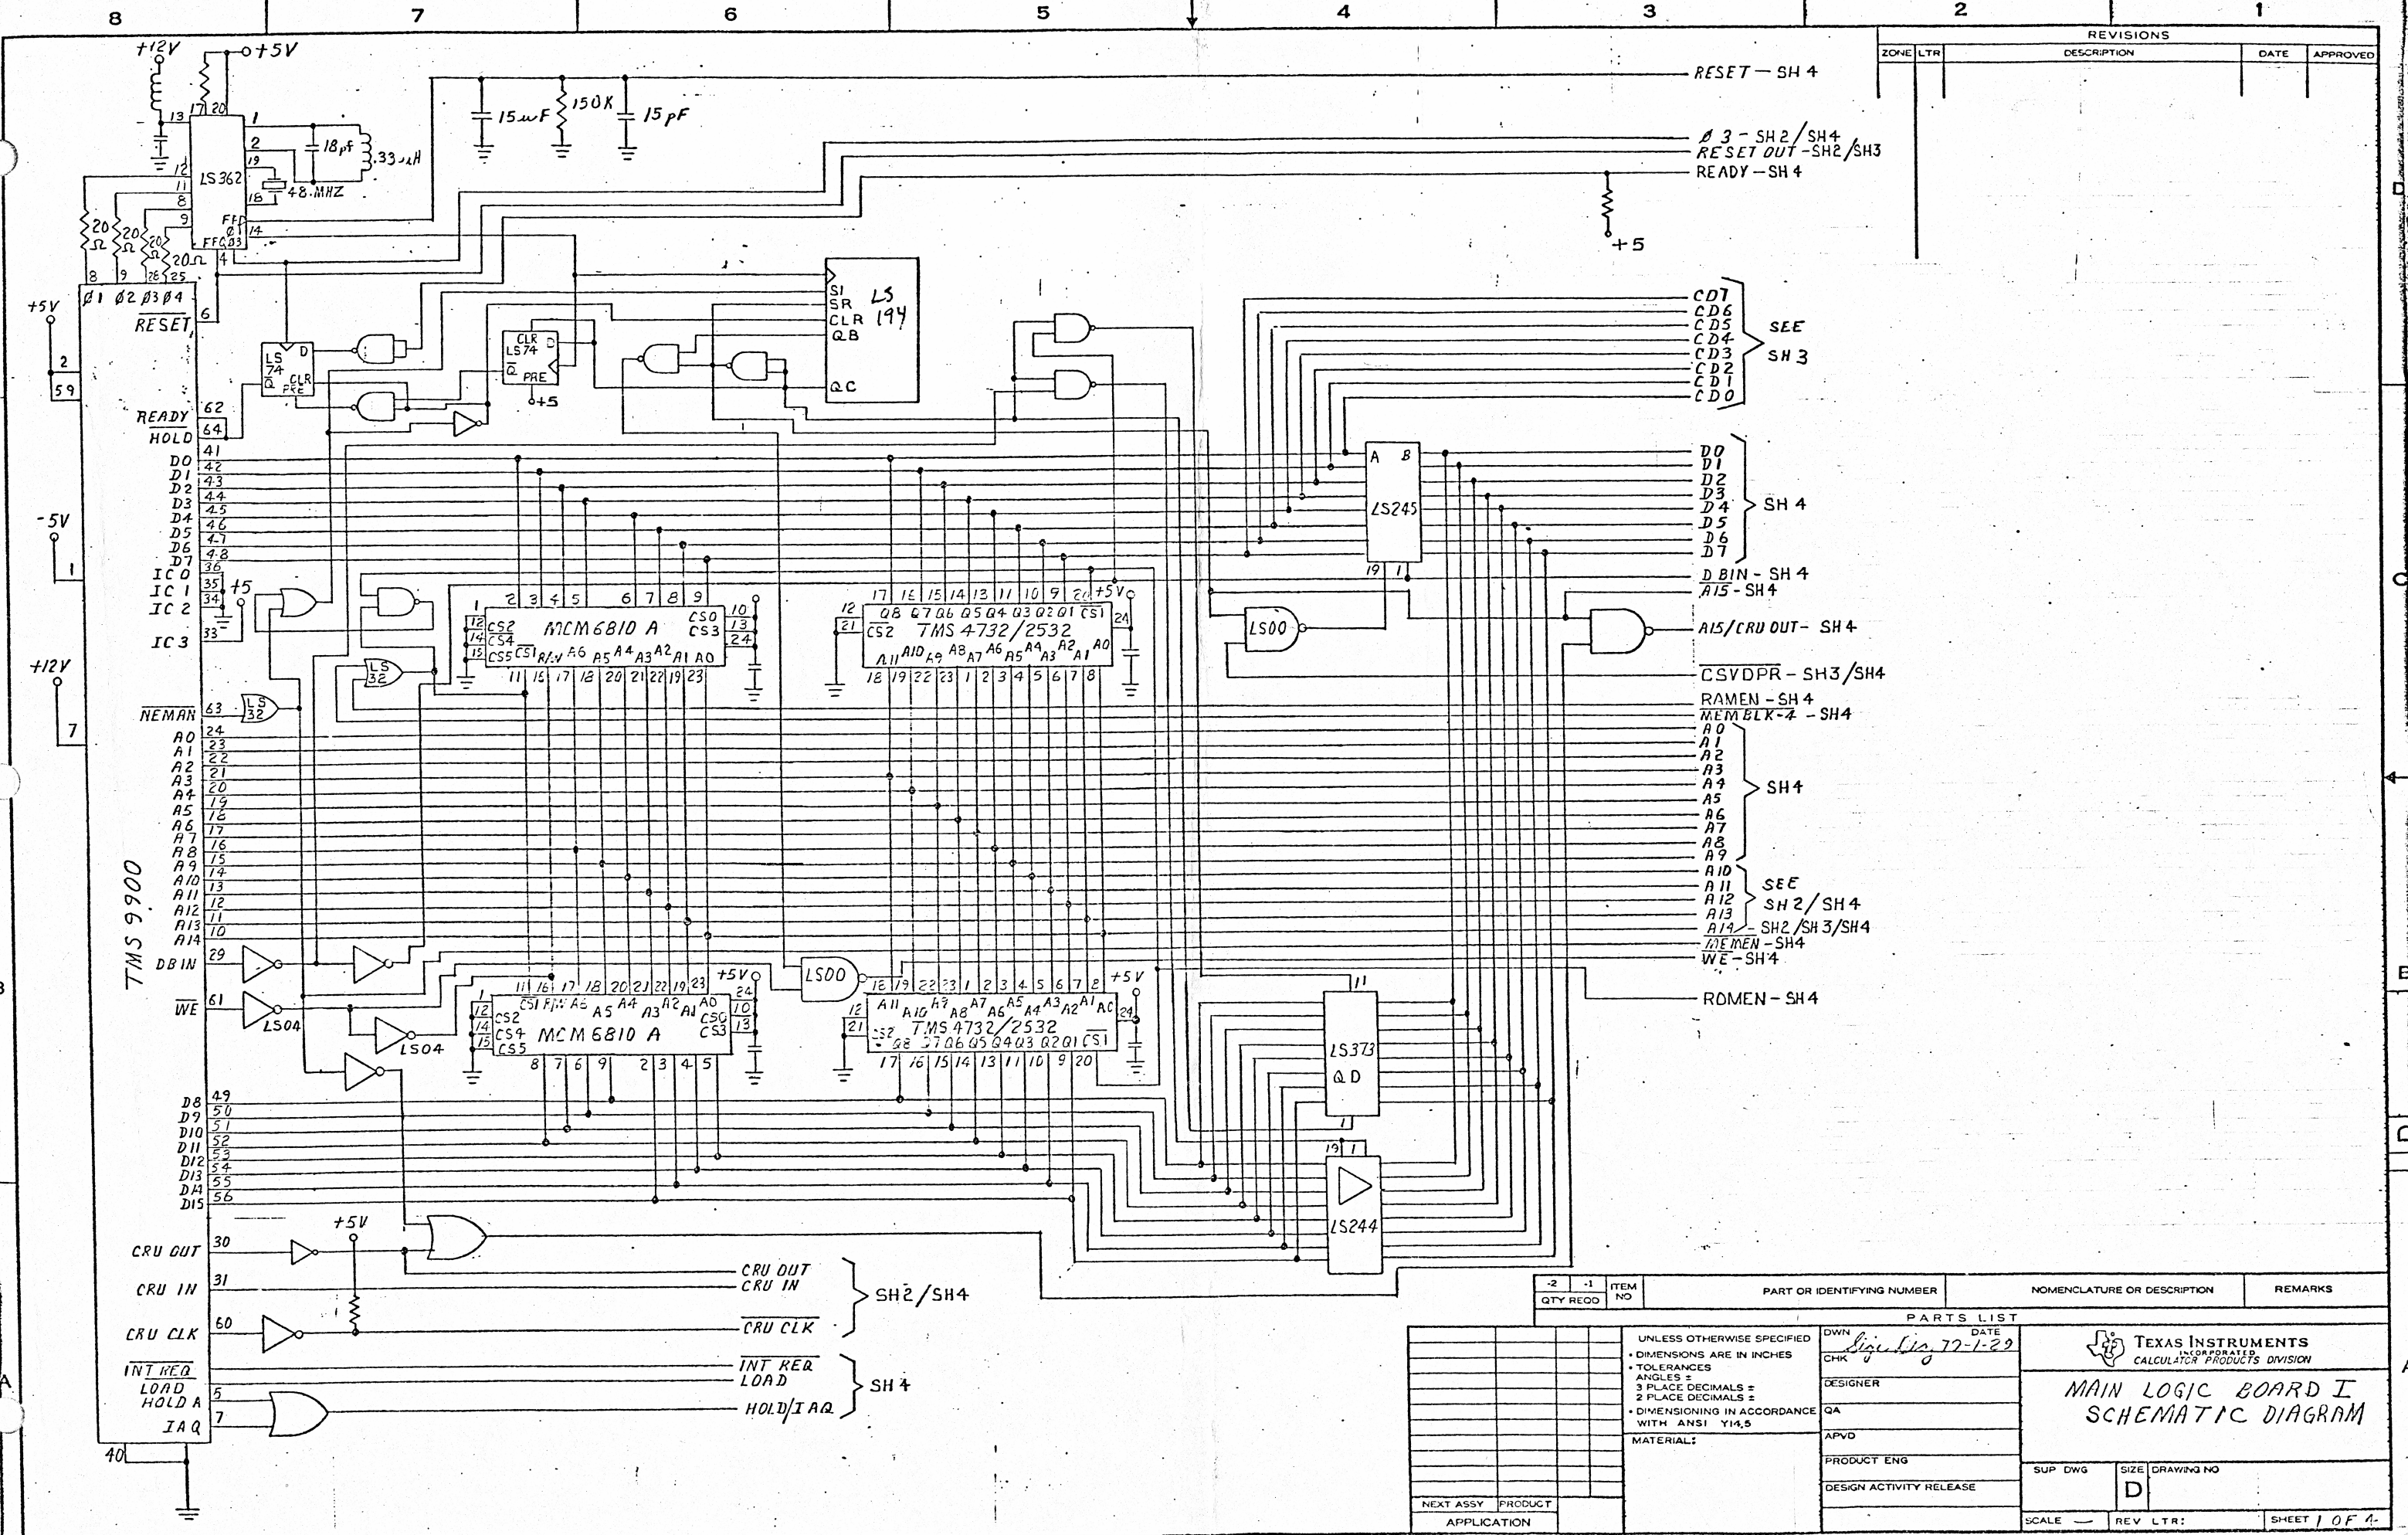

REVISIONS				
ZONE	LTR	DESCRIPTION	DATE	APPROVED

-2	-1	ITEM NO	PART OR IDENTIFYING NUMBER	NOMENCLATURE OR DESCRIPTION	REMARKS

PARTS LIST	
QTY	DESCRIPTION


UNLESS OTHERWISE SPECIFIED	DWN DATE
• DIMENSIONS ARE IN INCHES	CHK <i>Sign. 77-1-29</i>
• TOLERANCES	DESIGNER
• ANGLES =	QA
• 3 PLACE DECIMALS =	APVD
• 2 PLACE DECIMALS =	PRODUCT ENG
• DIMENSIONING IN ACCORDANCE WITH ANSI Y14.5	DESIGN ACTIVITY RELEASE

TEXAS INSTRUMENTS
INCORPORATED
CALCULATOR PRODUCTS DIVISION
**MAIN LOGIC BOARD I
SCHEMATIC DIAGRAM**

SUP DWG SIZE DRAWING NO
D
SCALE REV LTR: SHEET 1 OF 1

CLASS CODE:

REVISIONS				
ZONE	LTR	DESCRIPTION	DATE	APPROVED

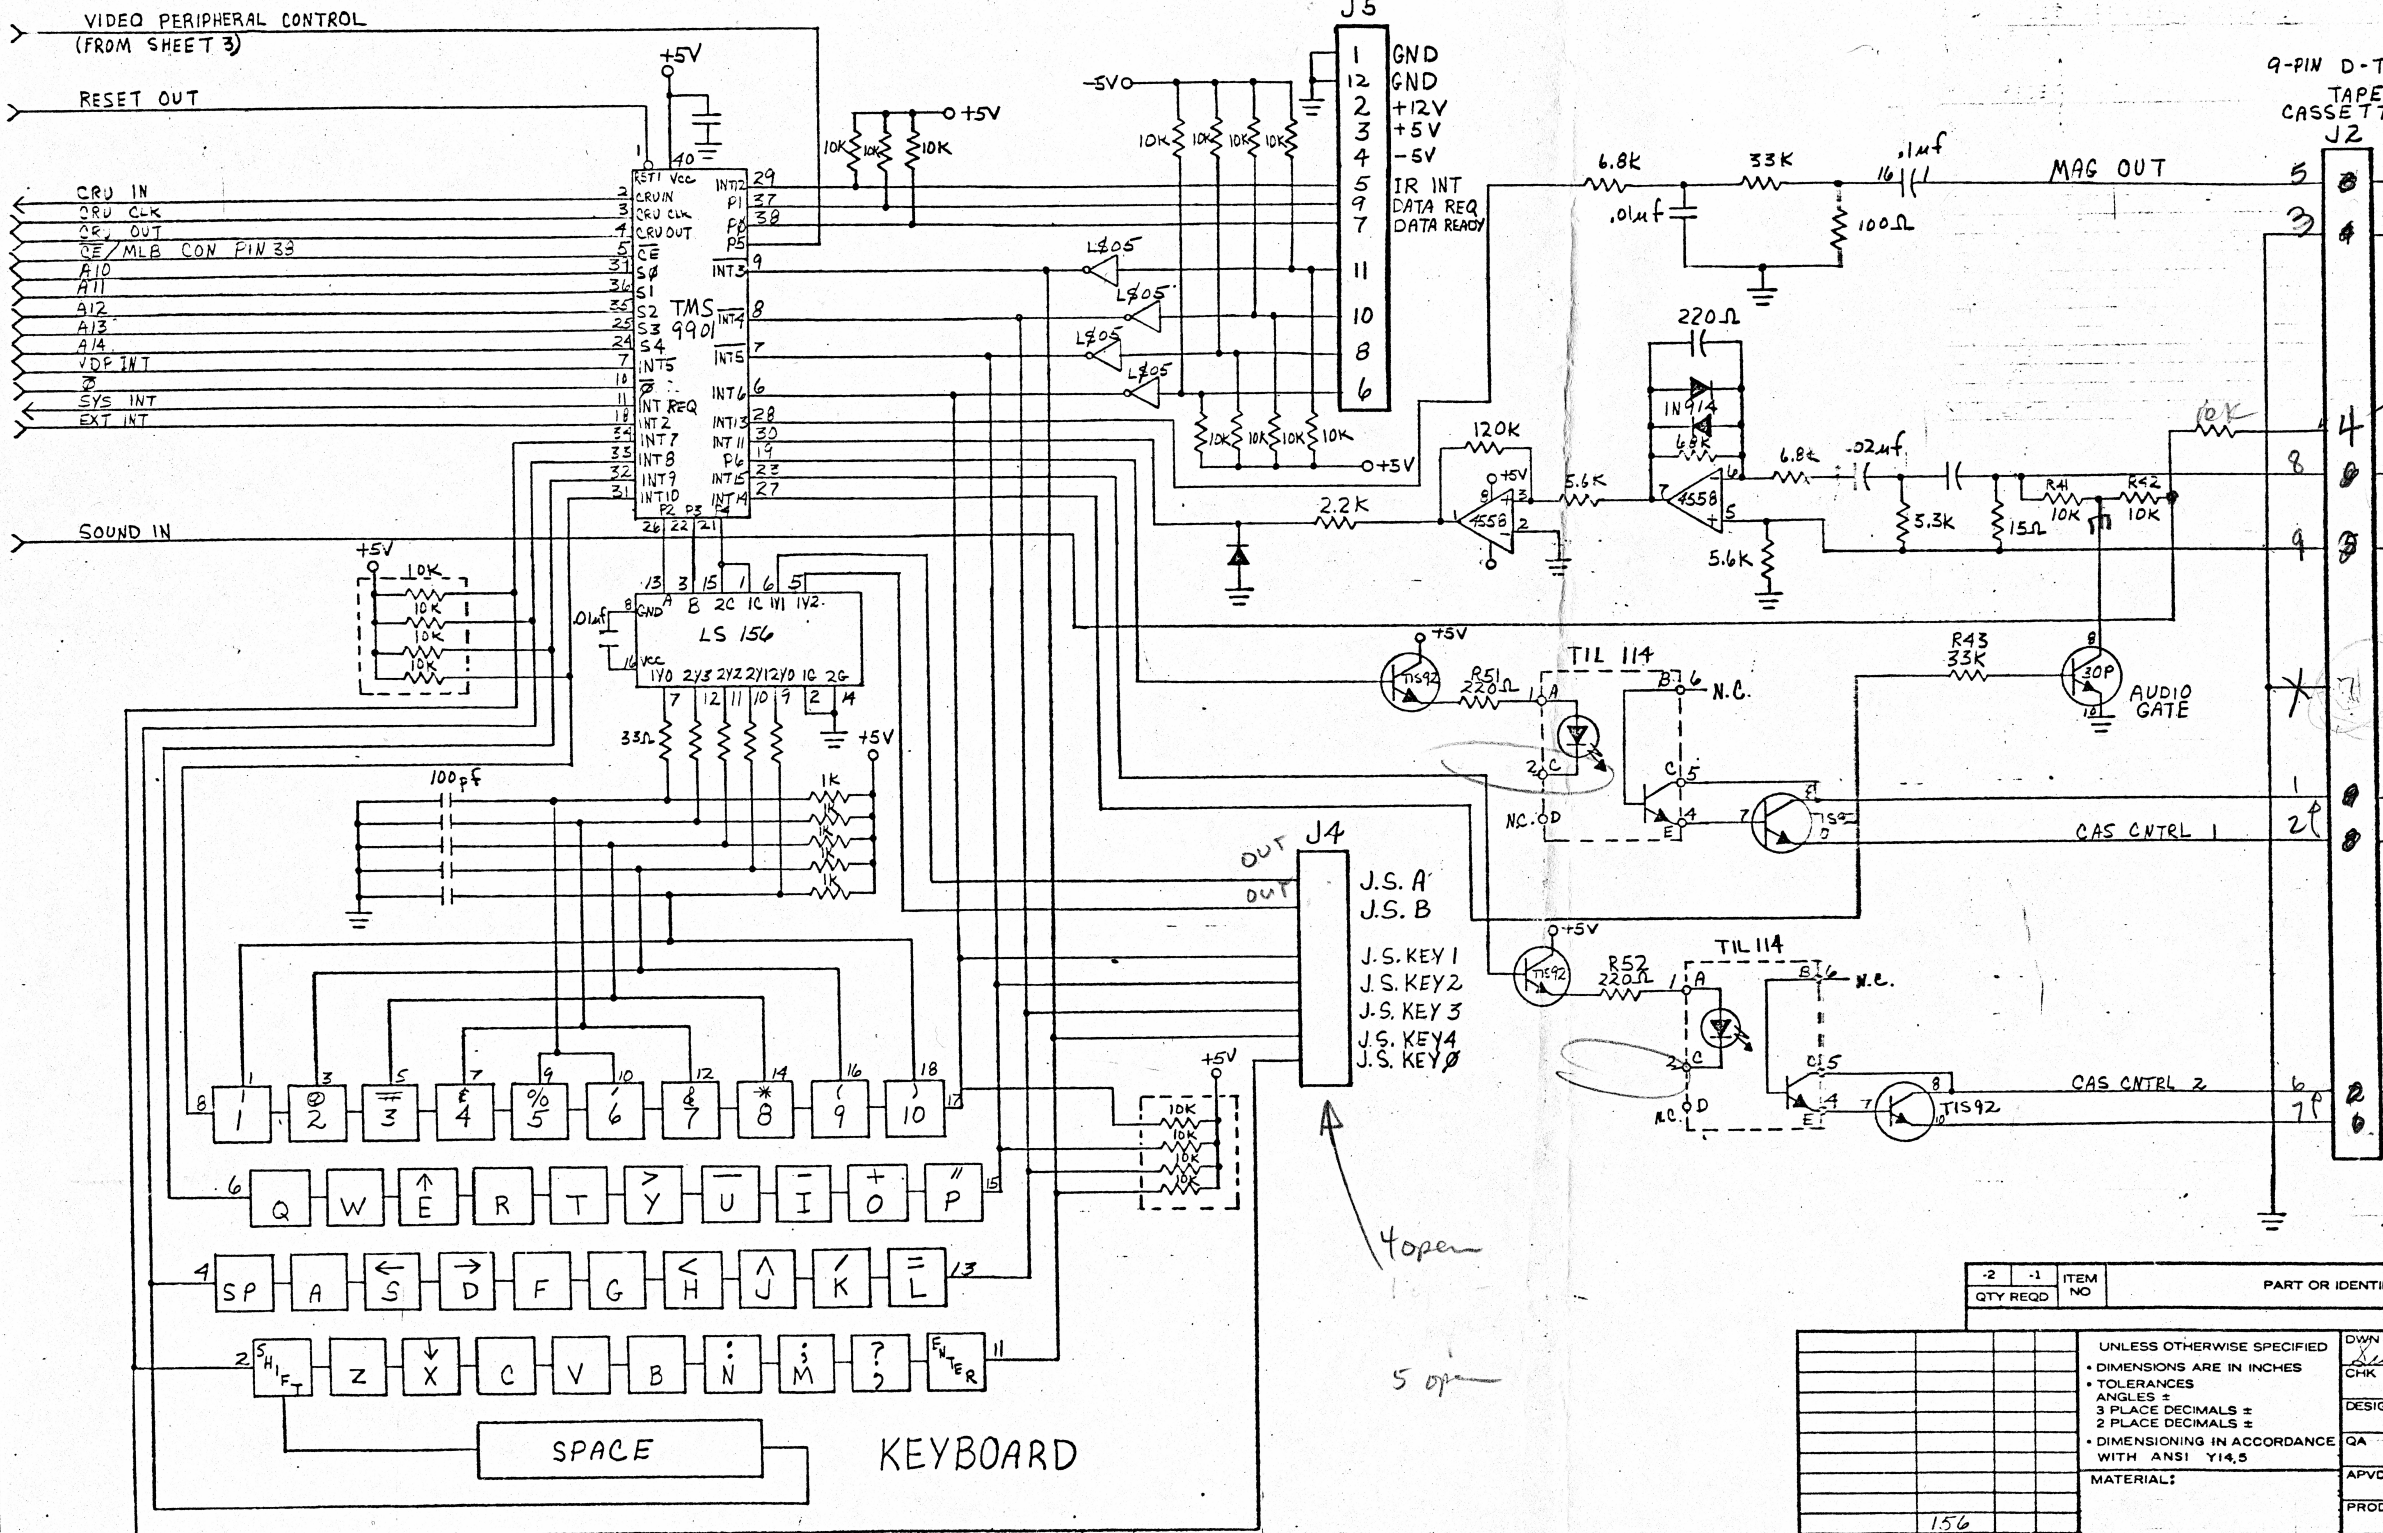

PRE-RELEASE
 SUBJECT TO CHANGE WITHOUT NOTICE
 FEB 1 1979
 DATE

-2	-1	ITEM NO	PART OR IDENTIFYING NUMBER	NOMENCLATURE OR DESCRIPTION	REMARKS

PARTS LIST	
QTY	DESCRIPTION

UNLESS OTHERWISE SPECIFIED • DIMENSIONS ARE IN INCHES • TOLERANCES • ANGLES = • 3 PLACE DECIMALS ± • 2 PLACE DECIMALS ± • DIMENSIONING IN ACCORDANCE WITH ANSI Y14.5	DWN DATE CHK DESIGNER QA APVD PRODUCT ENG DESIGN ACTIVITY RELEASE
MATERIAL:	TEXAS INSTRUMENTS INCORPORATED CALCULATOR PRODUCTS DIVISION
156 500 NEXT ASSY PRODUCT APPLICATION	ELECTRONIC SCHEMATIC DIAGRAM MAIN LOGIC BOARD PRODUCT 156
	SUP DWG SIZE DRAWING NO. D
	SCALE REV LTR: SHEET 2 OF 4

